


J:\PROJECTS\Monroe County DOT\Highway PL21E As-Built Plans\Mt Read As-Built Plans (Britton to Latta) dgn
 DATE/TIME 5/17/2017 2:30:33 PM

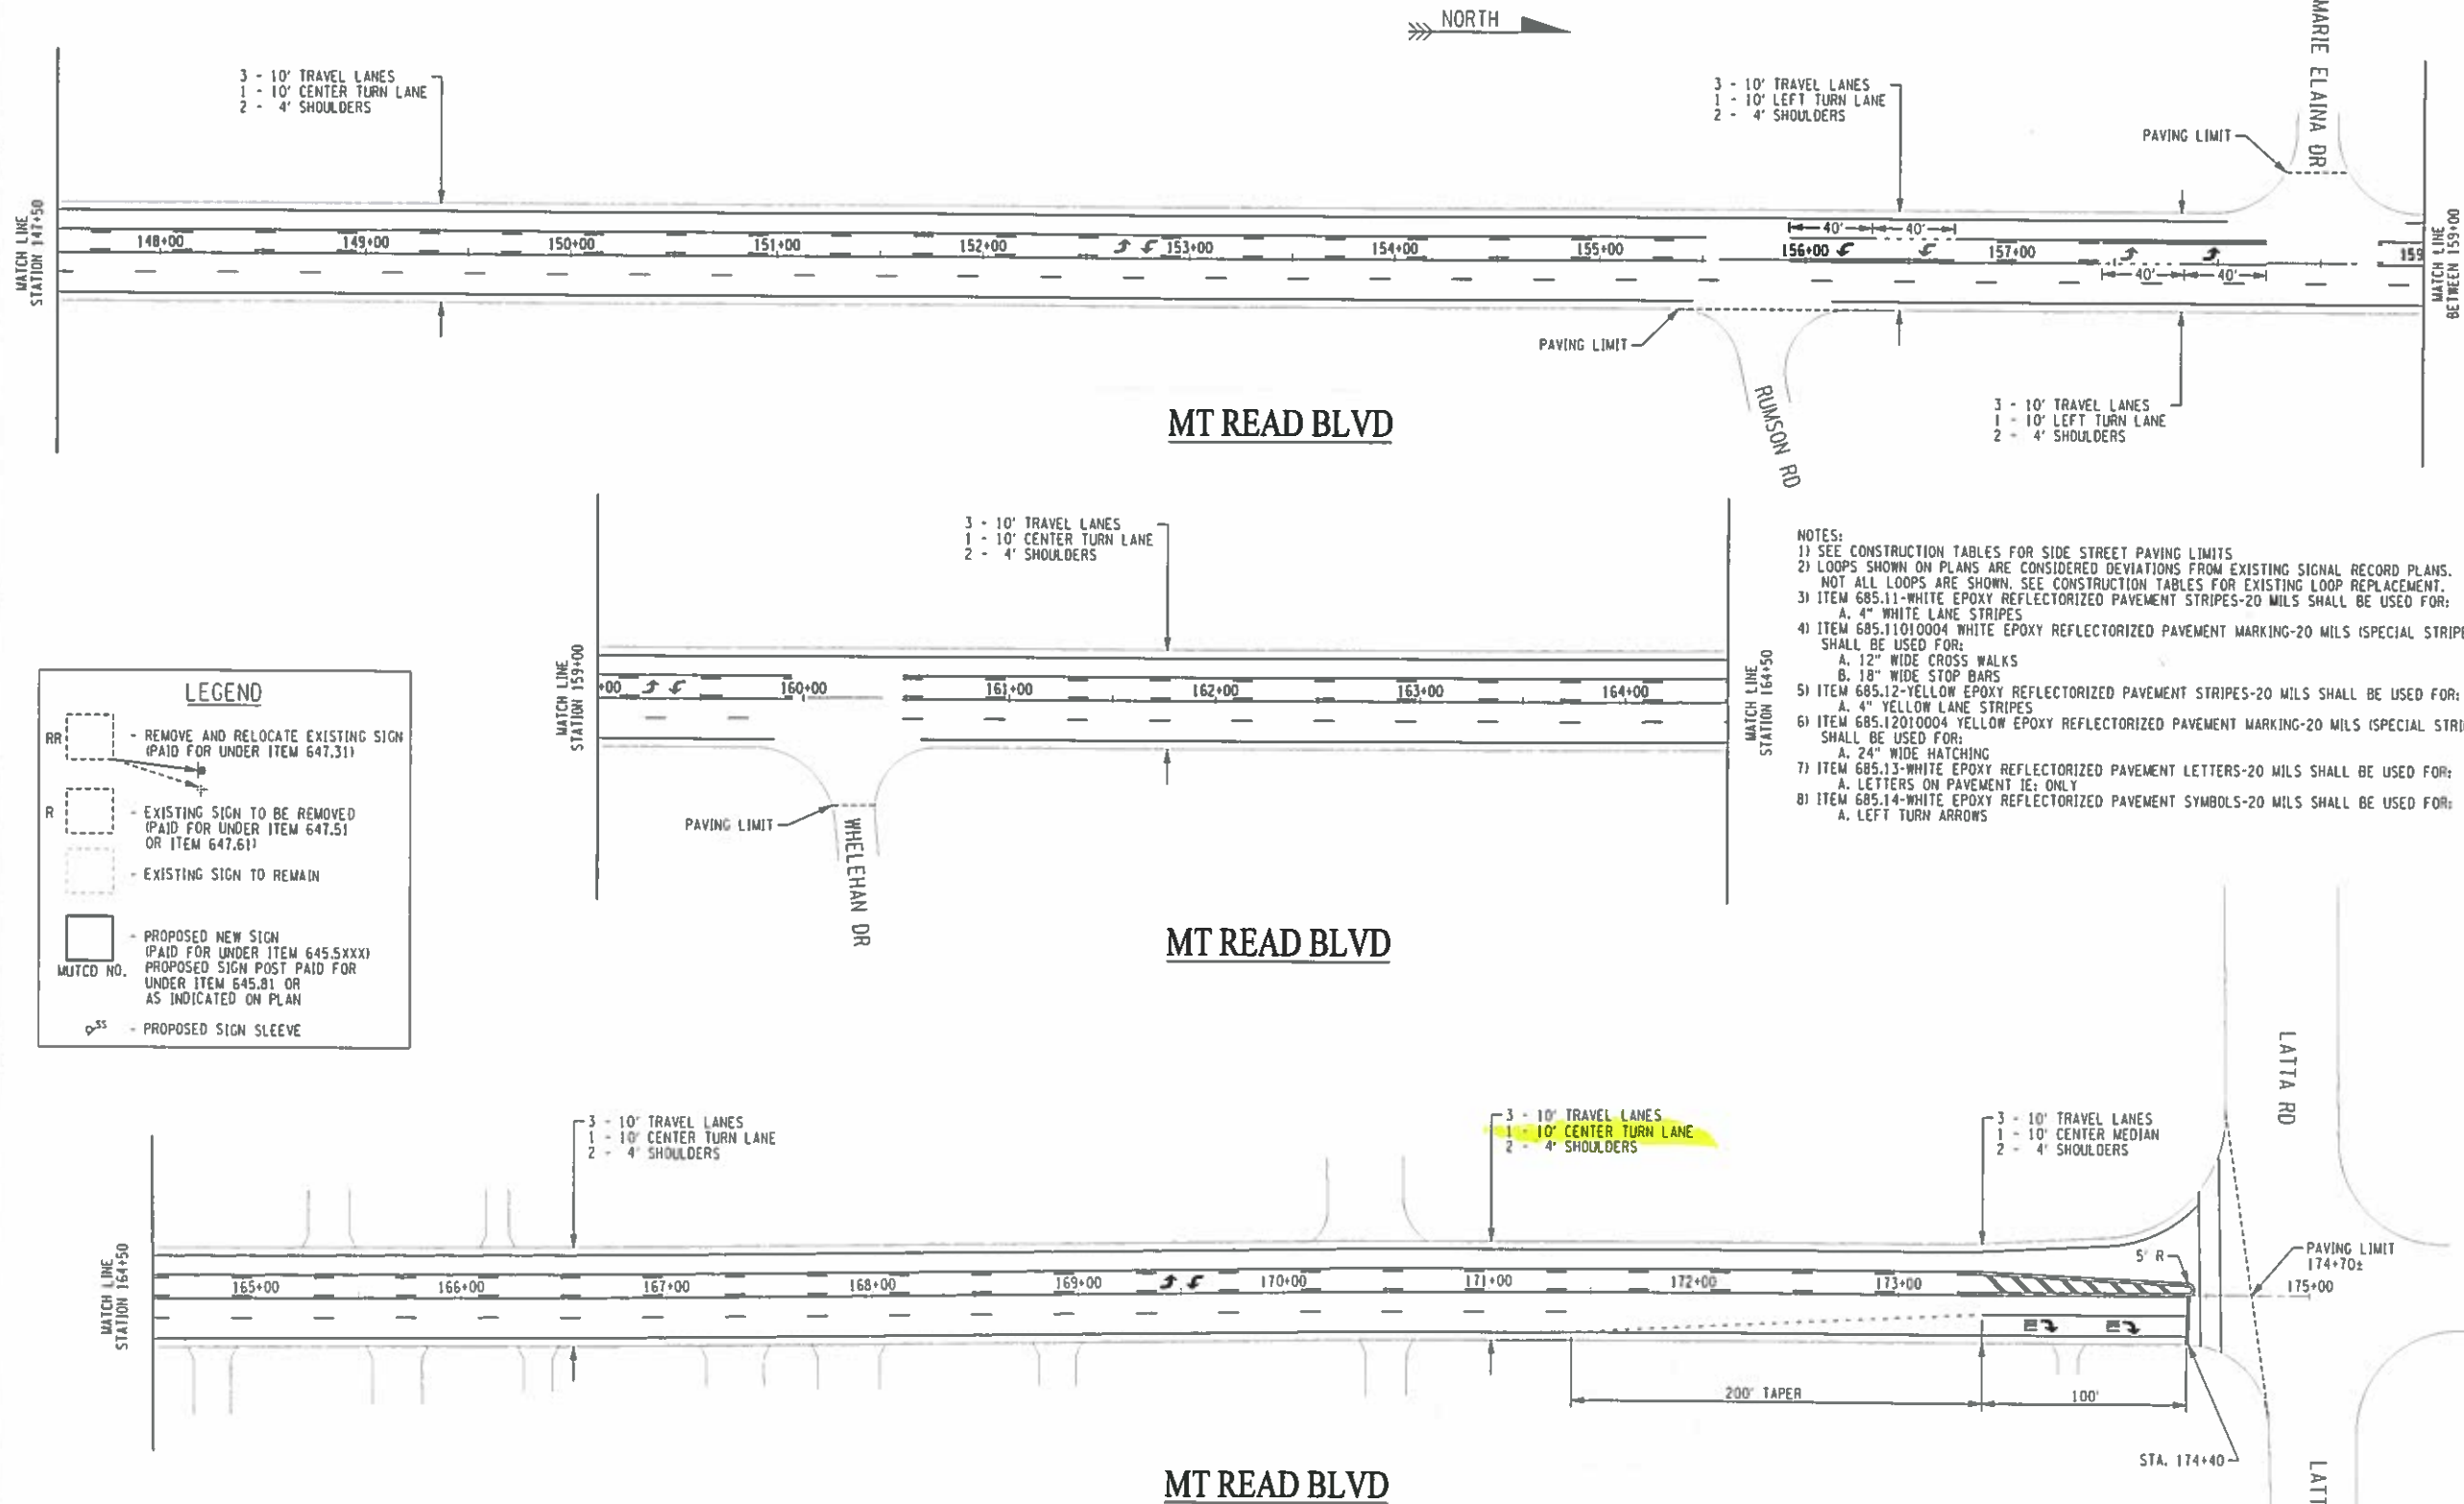

LEGEND

- RR - REMOVE AND RELOCATE EXISTING SIGN (PAID FOR UNDER ITEM 647.31)
- R - EXISTING SIGN TO BE REMOVED (PAID FOR UNDER ITEM 647.51 OR ITEM 647.61)
- - EXISTING SIGN TO REMAIN
- - PROPOSED NEW SIGN (PAID FOR UNDER ITEM 645.5XXX) PROPOSED SIGN POST PAID FOR UNDER ITEM 645.81 OR AS INDICATED ON PLAN
- - PROPOSED SIGN SLEEVE

- NOTES:**
- SEE CONSTRUCTION TABLES FOR SIDE STREET PAVING LIMITS.
 - LOOPS SHOWN ON PLANS ARE CONSIDERED DEVIATIONS FROM EXISTING SIGNAL RECORD PLANS. NOT ALL LOOPS ARE SHOWN. SEE CONSTRUCTION TABLES FOR EXISTING LOOP REPLACEMENT.
 - ITEM 685.11-WHITE EPOXY REFLECTORIZED PAVEMENT STRIPES-20 MILS SHALL BE USED FOR:
 - A. 4" WHITE LANE STRIPES
 - ITEM 685.11010004 WHITE EPOXY REFLECTORIZED PAVEMENT MARKING-20 MILS (SPECIAL STRIPES) SHALL BE USED FOR:
 - A. 12" WIDE CROSS WALKS
 - B. 18" WIDE STOP BARS
 - ITEM 685.12-YELLOW EPOXY REFLECTORIZED PAVEMENT STRIPES-20 MILS SHALL BE USED FOR:
 - A. 4" YELLOW LANE STRIPES
 - ITEM 685.12010004 YELLOW EPOXY REFLECTORIZED PAVEMENT MARKING-20 MILS (SPECIAL STRIPES) SHALL BE USED FOR:
 - A. 24" WIDE HATCHING
 - ITEM 685.13-WHITE EPOXY REFLECTORIZED PAVEMENT LETTERS-20 MILS SHALL BE USED FOR:
 - A. LETTERS ON PAVEMENT IE: ONLY
 - ITEM 685.14-WHITE EPOXY REFLECTORIZED PAVEMENT SYMBOLS-20 MILS SHALL BE USED FOR:
 - A. LEFT TURN ARROWS

RECORD PLANS



Clark Patterson Lee
 PROJECT MANAGER: DAVID ASKINAZI
 DRAWN BY: DAVID HASTINGS

DEPARTMENT OF TRANSPORTATION
 50 WEST MAIN STREET, SUITE 6100
 ROCHESTER, NEW YORK 14614-1231
 UNABRIDGED ADAPTATION OF SECTION 146, CHAPTER 146, SECTION 146 OF THE NEW YORK STATE CONVEYANCE LAW ARTICLE 146, SECTION 146

COUNTY ROAD
 PROJECT NAME: HIGHWAY PREVENTATIVE MAINTENANCE 2
 LIMITS: MT READ BLVD, BRITTON RD TO LATTA RD
 TOWN: GREECE
 CAPITAL PROJECT NO.: 4760.57
 DJ: 034847

MT READ BLVD
 BRITTON TO LATTA
 AS-BUILT PLANS
 SCALE: 1"=40'
 DATE ISSUED: 12/2015
 DRAWING NO: MRB-01
 SHEET NO: 02 OF 02