


FILE NAME = J:\PROJECTS\Monroe County DOT\Highway Plan\2E As-Built Plans\Ridgeway As-Built Plans.dgn
 DATE/TIME = 11/28/2017 11:47:01 AM

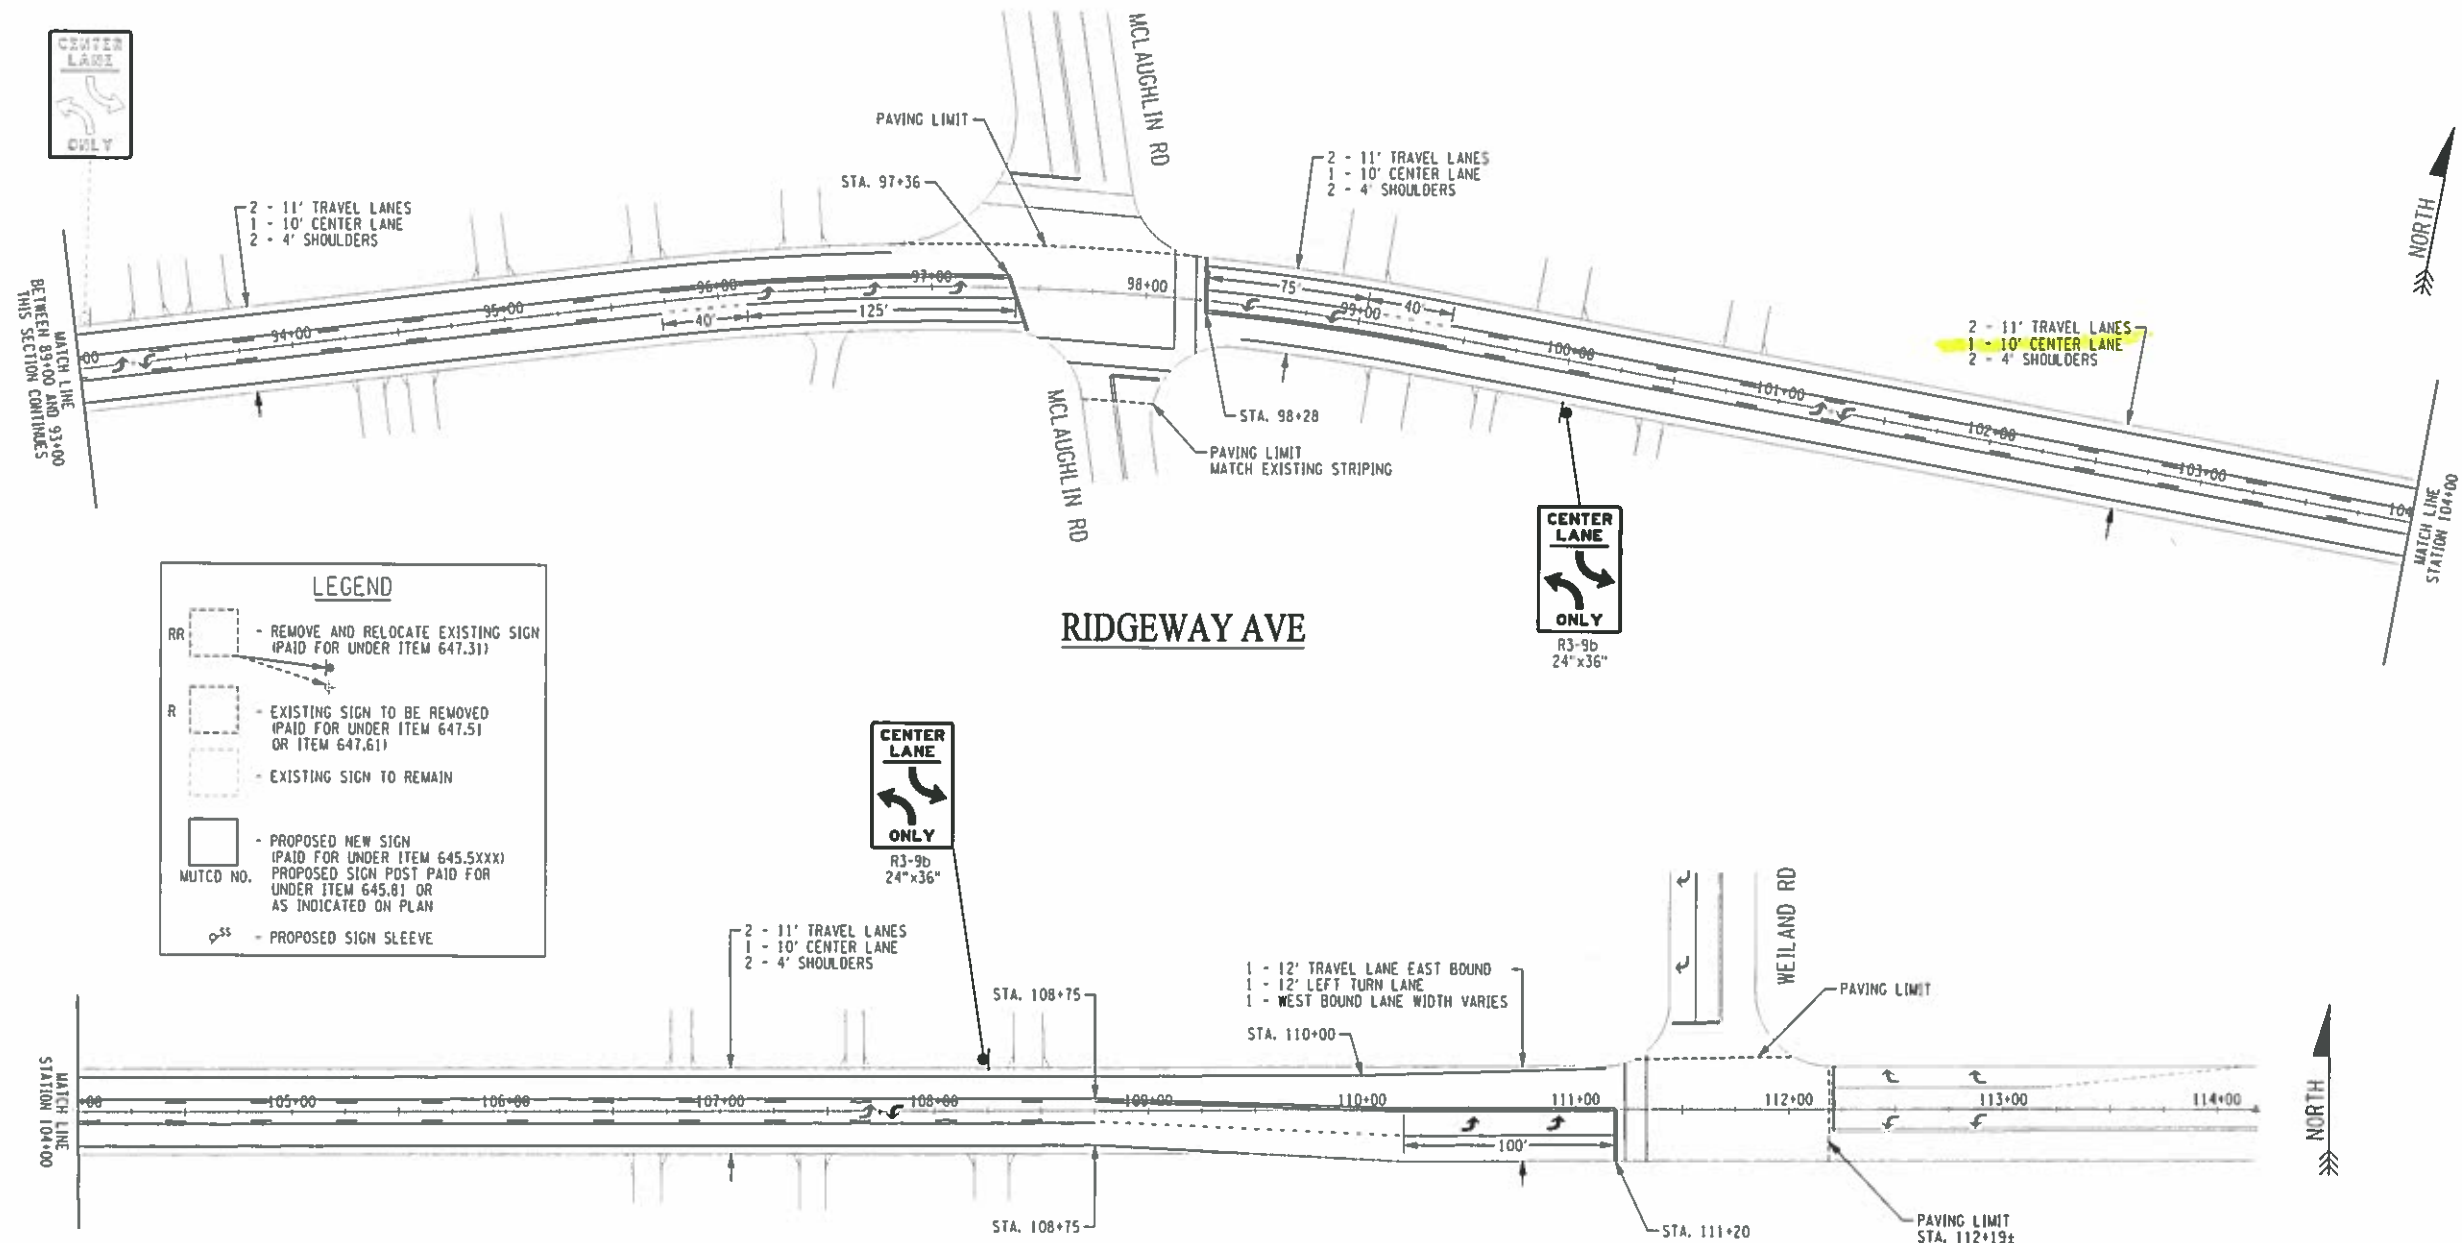

LEGEND

- RR - REMOVE AND RELOCATE EXISTING SIGN (PAID FOR UNDER ITEM 647.31)
- R - EXISTING SIGN TO BE REMOVED (PAID FOR UNDER ITEM 647.51 OR ITEM 647.61)
- - EXISTING SIGN TO REMAIN
- - PROPOSED NEW SIGN (PAID FOR UNDER ITEM 645.5XXX)
 PROPOSED SIGN POST PAID FOR UNDER ITEM 645.81 OR AS INDICATED ON PLAN
- SS - PROPOSED SIGN SLEEVE

MUTCD NO.

- NOTES:**
- 1) SEE CONSTRUCTION TABLES FOR SIDE STREET PAVING LIMITS
 - 2) LOOPS SHOWN ON PLANS ARE CONSIDERED DEVIATIONS FROM EXISTING SIGNAL RECORD PLANS. NOT ALL LOOPS ARE SHOWN. SEE CONSTRUCTION TABLES FOR EXISTING LOOP REPLACEMENT.
 - 3) ITEM 685.11-WHITE EPOXY REFLECTORIZED PAVEMENT STRIPES-20 MILS SHALL BE USED FOR:
 - A. 4" WHITE LANE STRIPES
 - 4) ITEM 685.11010004 WHITE EPOXY REFLECTORIZED PAVEMENT MARKING-20 MILS (SPECIAL STRIPES) SHALL BE USED FOR:
 - A. 12" WIDE CROSS WALKS
 - B. 18" WIDE STOP BARS
 - 5) ITEM 685.12-YELLOW EPOXY REFLECTORIZED PAVEMENT STRIPES-20 MILS SHALL BE USED FOR:
 - A. 4" YELLOW LANE STRIPES
 - 6) ITEM 685.12010004 YELLOW EPOXY REFLECTORIZED PAVEMENT MARKING-20 MILS (SPECIAL STRIPES) SHALL BE USED FOR:
 - A. 24" WIDE HATCHING
 - 7) ITEM 685.13-WHITE EPOXY REFLECTORIZED PAVEMENT LETTERS-20 MILS SHALL BE USED FOR:
 - A. LETTERS ON PAVEMENT IE: ONLY
 - 8) ITEM 685.14-WHITE EPOXY REFLECTORIZED PAVEMENT SYMBOLS-20 MILS SHALL BE USED FOR:
 - A. LEFT TURN ARROWS

RECORD PLANS



Clark Patterson Lee
 ARCHITECTURE ENGINEERING PLANNING
 PROJECT MANAGER: DAVID ASKINAZI
 DRAWN BY: DAVID HASTINGS

DEPARTMENT OF TRANSPORTATION
 50 WEST MAIN STREET, SUITE 6100
 ROCHESTER, NEW YORK 14614-1231
UNAUTHORIZED ALTERATION OF ANY PART OF THIS DRAWING IS A VIOLATION OF THE NEW YORK STATE ENGINEERING LAW ARTICLE 17-C, SECTION 1708

PROJECT NAME: COUNTY ROAD
 RIDGWAY AVE, LATONA RD TO CITY LINE
 TOWN: GREECE
 CAPITAL PROJECT NO.: 4760.57
 OF: 034847

RIDGWAY AVE AS-BUILT PLANS
 SCALE: 1" = 40'
 DATE ISSUED: 12/2015
 DRAWING NO. RW-02
 SHEET NO: 02 OF 02