


FILE NAME : J:\PROJECTS\Morroe County DOT\Highway PL20E As-Built Plans\ST Paul As-Built Plans.dgn
 DATE/TIME : 5/17/2017 2:42:00 PM

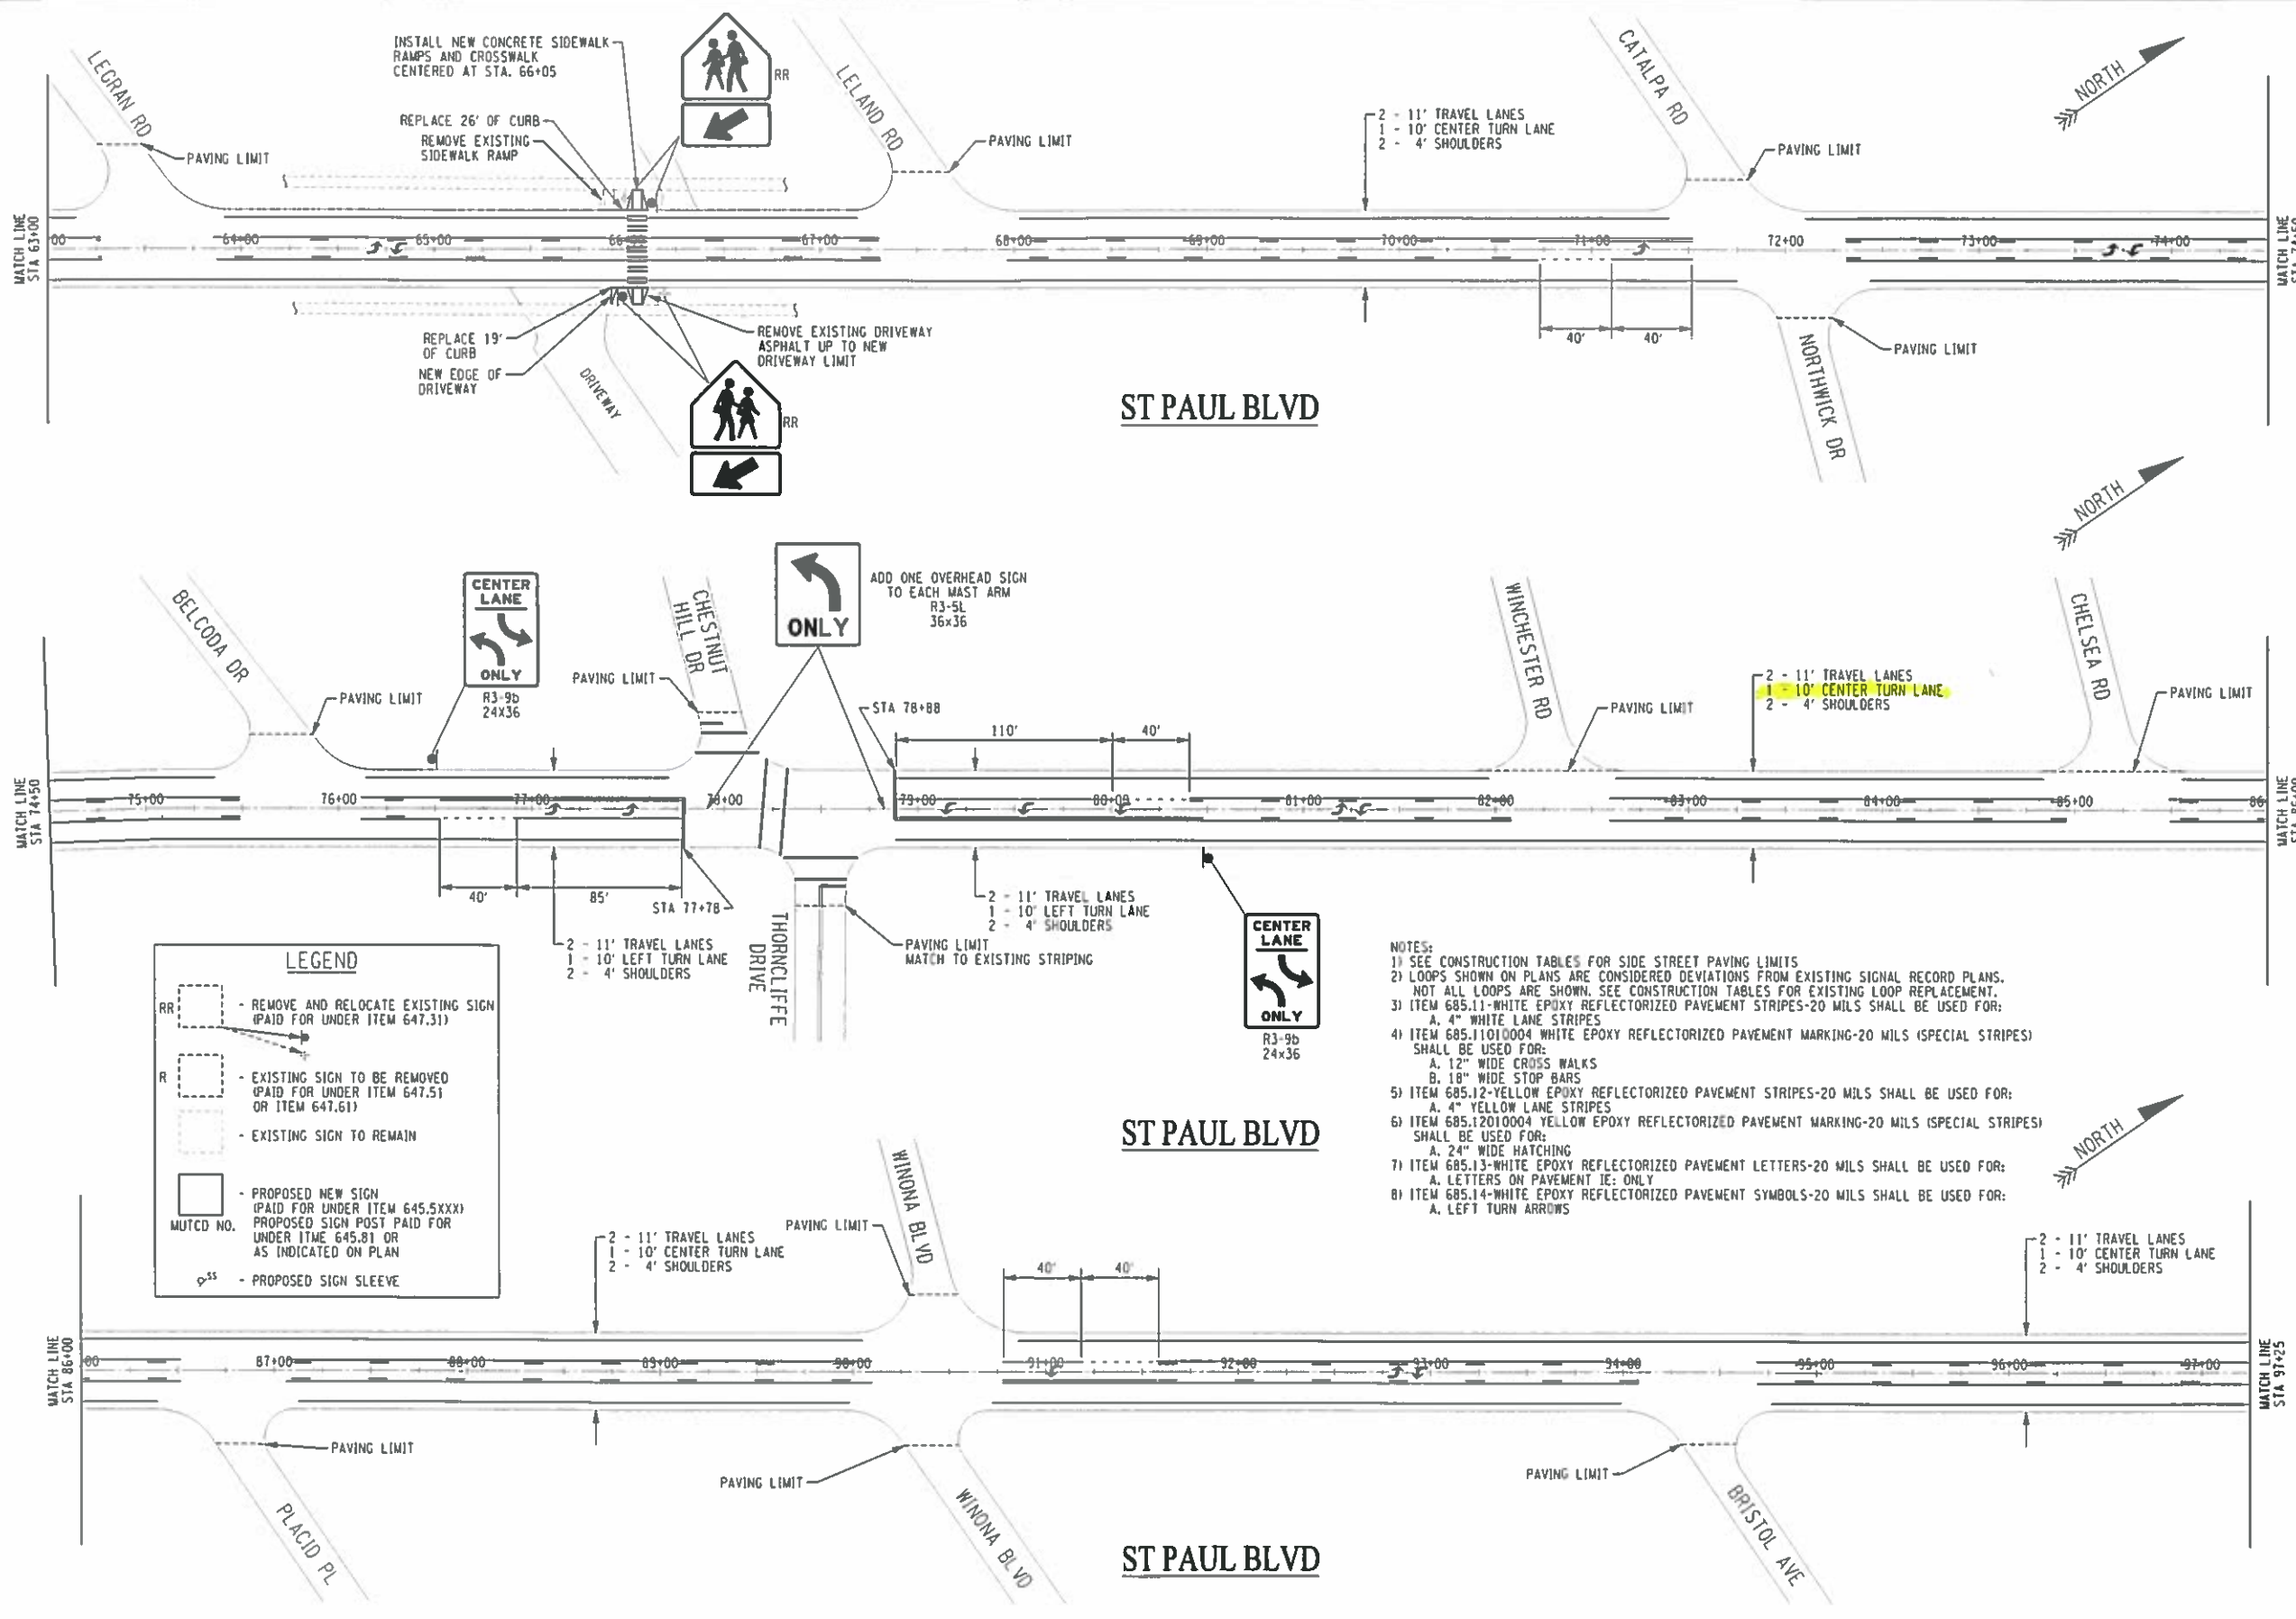

LEGEND

- REMOVE AND RELOCATE EXISTING SIGN (PAID FOR UNDER ITEM 647.31)
- EXISTING SIGN TO BE REMOVED (PAID FOR UNDER ITEM 647.51 OR ITEM 647.61)
- EXISTING SIGN TO REMAIN
- PROPOSED NEW SIGN (PAID FOR UNDER ITEM 645.SXXX) PROPOSED SIGN POST PAID FOR UNDER ITEM 645.81 OR AS INDICATED ON PLAN
- PROPOSED SIGN SLEEVE

- NOTES:**
- 1) SEE CONSTRUCTION TABLES FOR SIDE STREET PAVING LIMITS.
 - 2) LOOPS SHOWN ON PLANS ARE CONSIDERED DEVIATIONS FROM EXISTING SIGNAL RECORD PLANS. NOT ALL LOOPS ARE SHOWN. SEE CONSTRUCTION TABLES FOR EXISTING LOOP REPLACEMENT.
 - 3) ITEM 685.11-WHITE EPOXY REFLECTORIZED PAVEMENT STRIPES-20 MILS SHALL BE USED FOR:
 - A. 4" WHITE LANE STRIPES
 - 4) ITEM 685.11010004 WHITE EPOXY REFLECTORIZED PAVEMENT MARKING-20 MILS (SPECIAL STRIPES) SHALL BE USED FOR:
 - A. 12" WIDE CROSS WALKS
 - B. 18" WIDE STOP BARS
 - 5) ITEM 685.12-YELLOW EPOXY REFLECTORIZED PAVEMENT STRIPES-20 MILS SHALL BE USED FOR:
 - A. 4" YELLOW LANE STRIPES
 - 6) ITEM 685.12010004 YELLOW EPOXY REFLECTORIZED PAVEMENT MARKING-20 MILS (SPECIAL STRIPES) SHALL BE USED FOR:
 - A. 24" WIDE HATCHING
 - 7) ITEM 685.13-WHITE EPOXY REFLECTORIZED PAVEMENT LETTERS-20 MILS SHALL BE USED FOR:
 - A. LETTERS ON PAVEMENT IE: ONLY
 - 8) ITEM 685.14-WHITE EPOXY REFLECTORIZED PAVEMENT SYMBOLS-20 MILS SHALL BE USED FOR:
 - A. LEFT TURN ARROWS

RECORD PLANS



Clark Patterson Lee
 ARCHITECTURE (LICENSED IN NY AND NJ)
 PROJECT MANAGER: DAVID ASKINAZI
 DRAWN BY: DAVID HASTINGS

DEPARTMENT OF TRANSPORTATION
 50 WEST MAIN STREET, SUITE 6100
 ROCHESTER, NEW YORK 14614-1231
UNAUTHORIZED ALTERATION OR ADDITION TO THIS DRAWING IS A VIOLATION OF THE NEW YORK STATE EDUCATION LAW ARTICLE 145, SECTION 7508

COUNTY ROAD
 HIGHWAY PREVENTATIVE MAINTENANCE 2
 ST PAUL BLVD. CITY LINE TO NORTH END
 TOWN: IRONDEQUOIT
 CAPITAL PROJECT NO.: 4760.57
 DJ: 034847

ST PAUL BLVD
 AS-BUILT PLANS
 SCALE: 1"=40'
 DATE ISSUED: 12/2015
 DRAWING NO.: SPB-03
 SHEET NO: 03 OF 08