


FIG VI LLC  
(REPUTED OWNER)  
725 WEILAND RD  
TA\*089J2-1-3  
LJ1205 PJJ

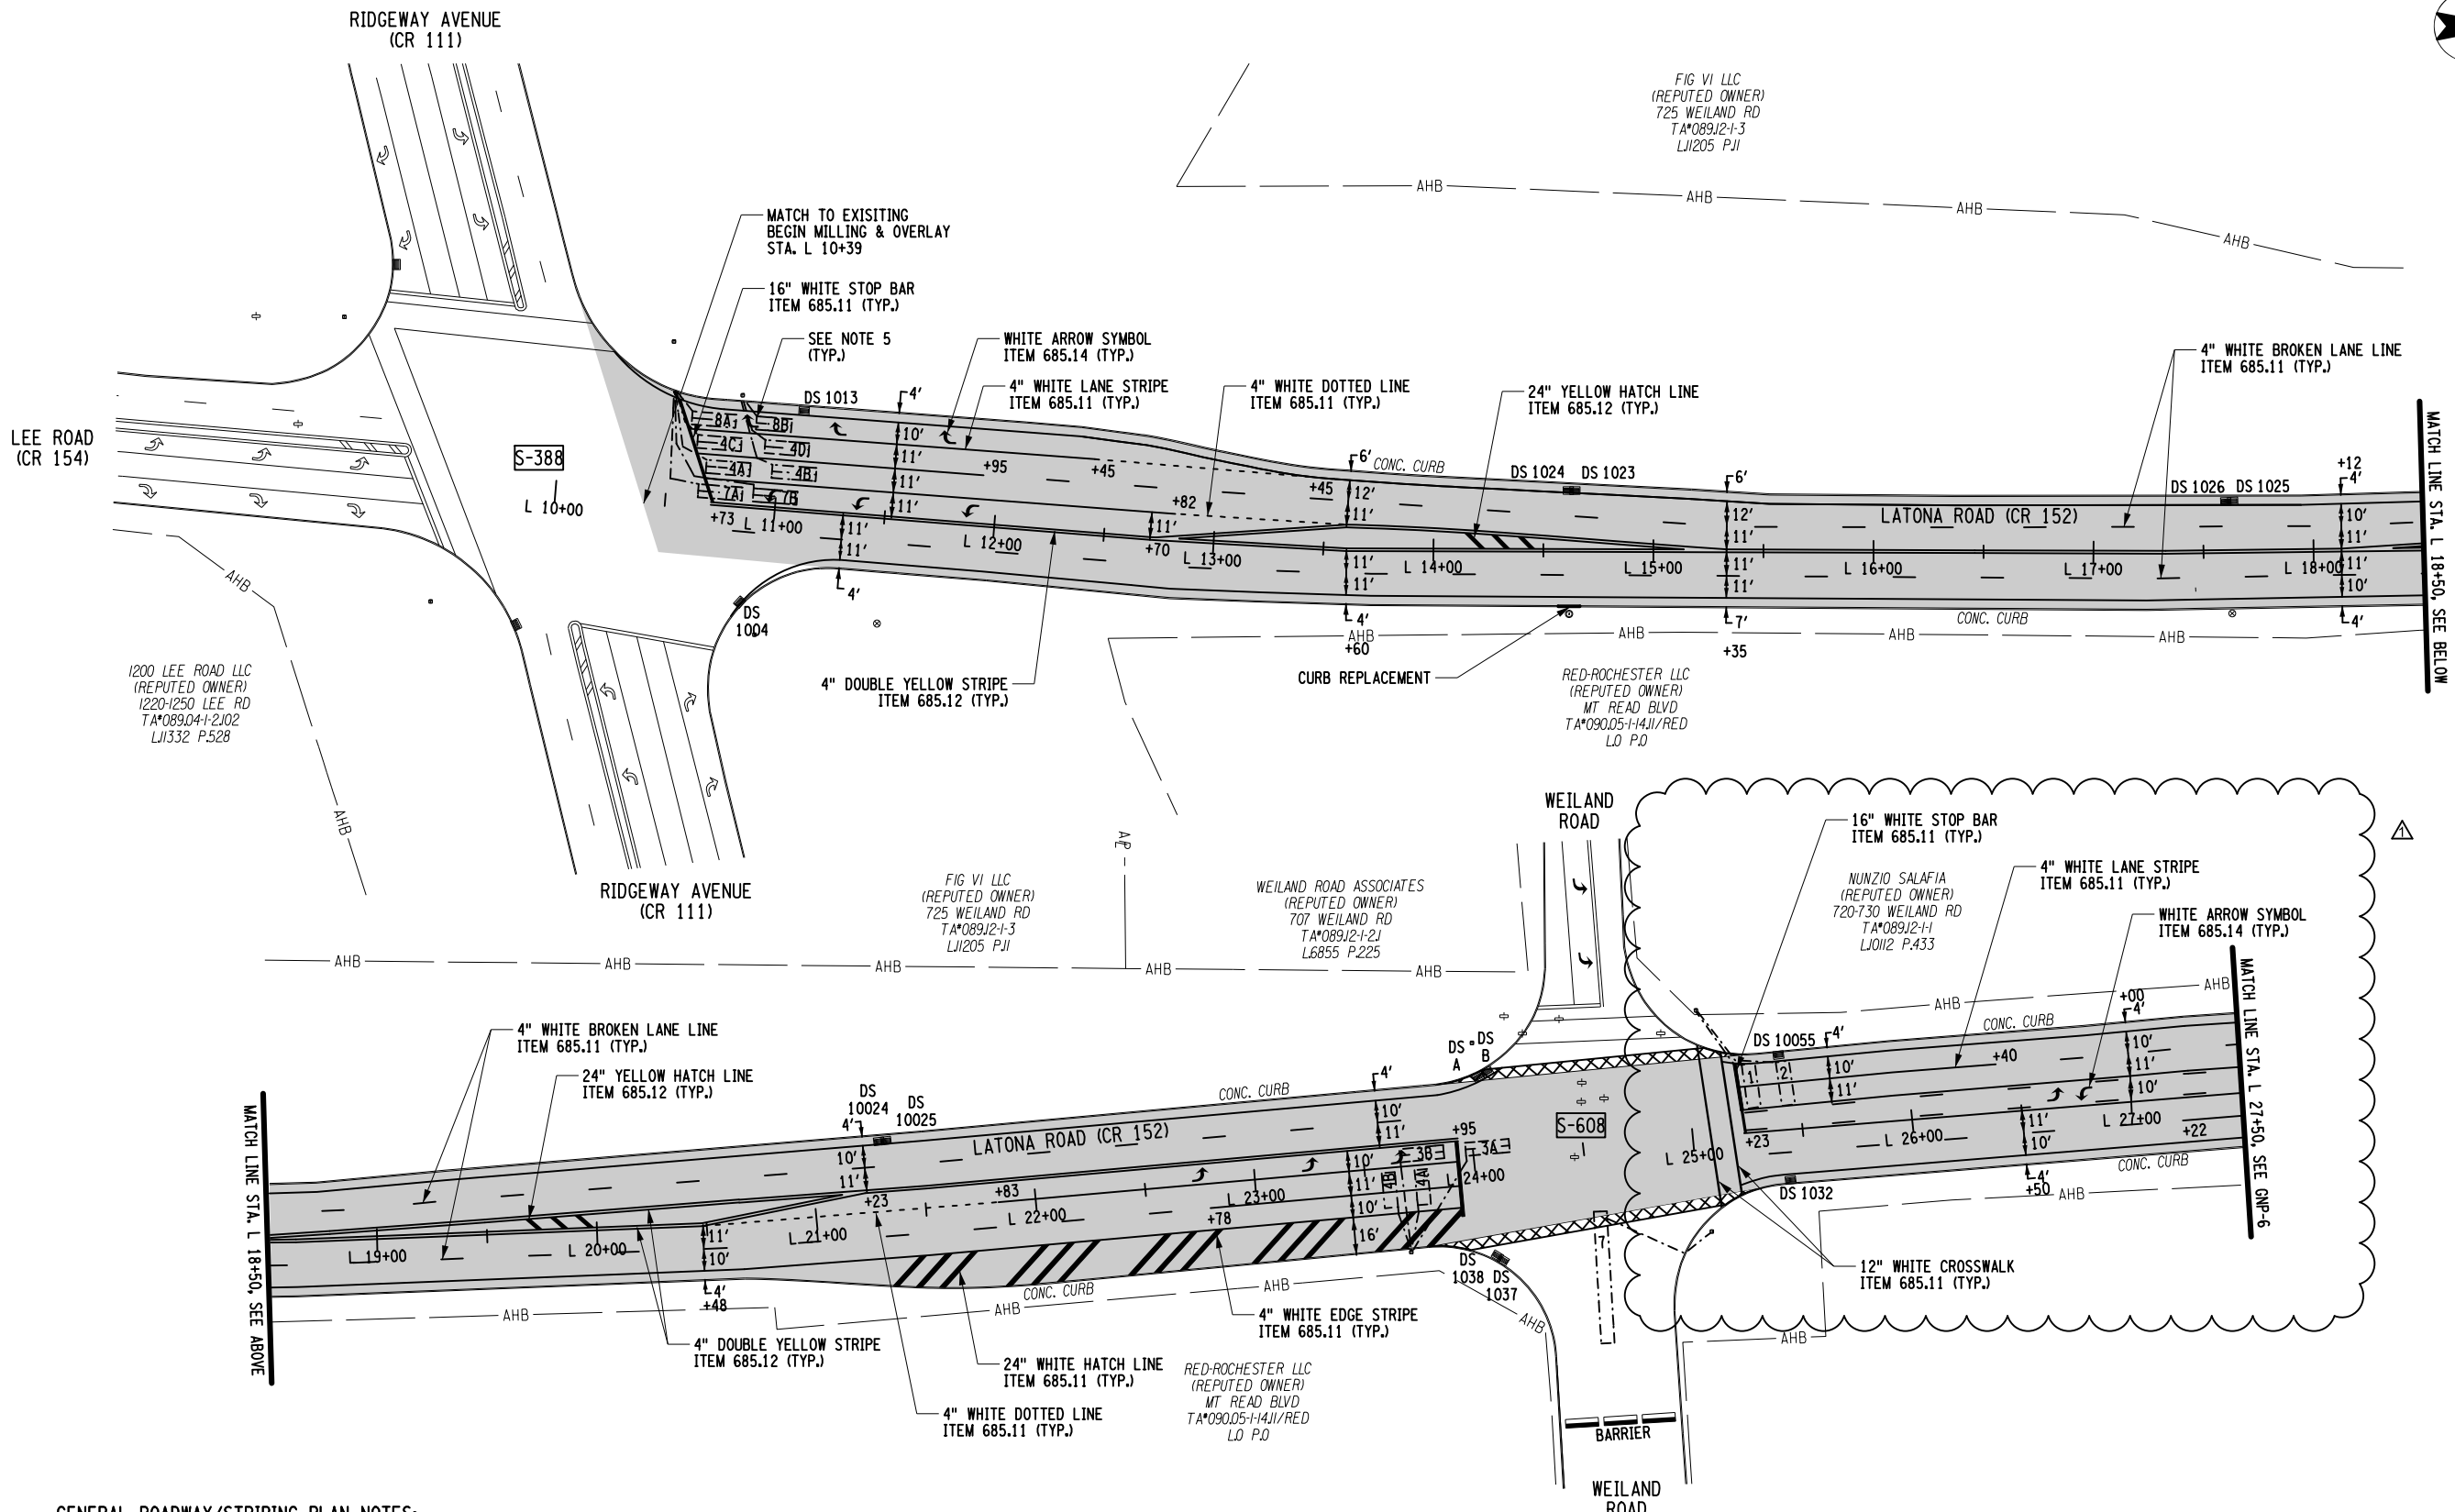


THIS DRAWING SUPERSEDES THE ORIGINAL DRAWING

**GENERAL ROADWAY/STRIPING PLAN NOTES:**

1. THE PAVEMENT MARKINGS SHOWN ON THESE PLANS ARE APPROXIMATE AND DISPLAYED FOR REFERENCE ONLY. PRIOR TO THE START OF ANY WORK OPERATIONS, THE CONTRACTOR SHALL VERIFY THE EXISTING PAVEMENT MARKINGS AND THEIR LOCATIONS. THE CONTRACTOR SHALL BE RESPONSIBLE FOR THE RE-ESTABLISHMENT OF THESE MARKINGS BASED ON THEIR INVENTORY AND RECORD PLANS, IF AVAILABLE.
2. REFER TO THE CONSTRUCTION DETAILS FOR STANDARD PAVEMENT MARKINGS AT INTERSECTIONS. PAVEMENT MARKINGS AT STATE INTERSECTIONS SHALL COMPLY WITH STANDARD SHEET 685-01.
3. ALL EXISTING SIGNS SHALL REMAIN UNLESS SHOWN OTHERWISE
4. ALL EXISTING SIDEWALKS AND ADA RAMPS SHALL REMAIN EXCEPT AS NOTED. REFER TO MISC. TABLES AND DETAILS FOR LOCATIONS AND PAY ITEMS.
5. THE CONTRACTOR SHALL REPLACE ALL TRAFFIC SIGNAL LOOPS IN KIND, THAT ARE WITHIN THE MILLED PAVEMENT AREA. REFER TO MISC. TABLES & DETAILS FOR LOCATION AND PAY ITEMS.
6. THE CONTRACTOR SHALL CLEAN ALL CLOSED DRAINAGE WITHIN THE COUNTY ROW. REFER TO MISC. TABLES FOR LOCATION AND PAY ITEMS.
7. THE CONTRACTOR SHALL ADJUST ALL FRAMES AND COVERS TO FINISH ELEVATION, ALL UTILITY COMPANIES SHALL BE CONSULTED AND COORDINATED WITH AS REQUIRED.
8. THE CONTRACTOR SHALL PROVIDE TEMPORARY STRIPING TO THE NEW CONFIGURATION AS NECESSARY.
9. THE CONTRACTOR SHALL TRANSITION ALL CURB RADIUS MODIFICATIONS DOWN TO FLUSH WITH FINISHED GRADE IN 6FT LENGTHS.

**LEGEND**

- ITEM 490.10 - PRODUCTION COLD MILLING OF BITUMINOUS CONCRETE
- ITEM 490.30 - MISCELLANEOUS COLD MILLING OF BITUMINOUS CONCRETE
- TRAFFIC SIGNAL NO.

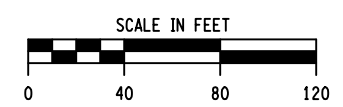

Design File: U:\19250032\11Transportation\Design\Drawings\Plan Set\GNP\GNP\_D6R1.dgn  
Date/Time: 4/14/2017 7:47:45 AM  
Plotted By: sromeliser

		Stantec Consulting Services Inc. 60 Commercial Street, Suite 100 Rochester, NY 14614 Tel: (585) 745-1440 Fax: (585) 272-1814 www.stantec.com	
PROJECT MANAGER: <b>B. WALKER</b>		DRAWN BY: <b>S. ROMEISER</b>	
DEPARTMENT OF TRANSPORTATION 50 WEST MAIN STREET, SUITE 6100 ROCHESTER, NEW YORK 14614-1231 <small>UNAUTHORIZED REPRODUCTION OR ADAPTATION OF THIS DRAWING IS A VIOLATION OF THE NEW YORK STATE EDUCATION LAW, ARTICLE 145, SECTION 7209</small>			
PROJECT NAME: HIGHWAY PREVENTIVE MAINTENANCE #4	ROADWAY: LATONA ROAD, CR 152	TOWN: GREECE	CAPITAL PROJECT NO.: 1740
LATONA ROAD PLAN STA. L 10+00 TO STA. L 27+50		P.I.N. 4760.59	SCALE: 1"=40' DATE ISSUED: 11/04/2016 DRAWING NO.: GNP-5R1
		NO. DATE BY: REVISIONS:	