SIGN LEGEND

- RR SIGN — REMOVE AND RELOCATE EXISTING SIGN
- EXISTING LOCATION
- NEW LOCATION
- R SIGN — EXISTING SIGN TO BE REMOVED
- SIGN — EXISTING SIGN TO REMAIN
- SIGN — PROPOSED NEW SIGN
- EXISTING SIGN
- PROPOSED SIGN

NOTES:

ALL STREET NAME SIGNS SHALL HAVE THE FOLLOWING BACKGROUND COLOR:

- CITY STREETS - BLUE BACKGROUND
- COUNTY ROADS - GREEN BACKGROUND

ALL GROUND MOUNTED REGULATORY (EXCLUDING PARKING) AND WARNING SIGNS SHALL BE FABRICATED USING ASTM TYPE III OR IX RETROREFLECTIVE SHEETING.

ALL OVERHEAD MOUNTED SIGNS SHALL BE FABRICATED USING ASTM TYPE IX RETROREFLECTIVE SHEETING.

✱ ALL GROUND AND POLE MOUNTED STREET NAME SIGNS SHALL BE TWO SIGNS EACH, MOUNTED BACK-TO-BACK.

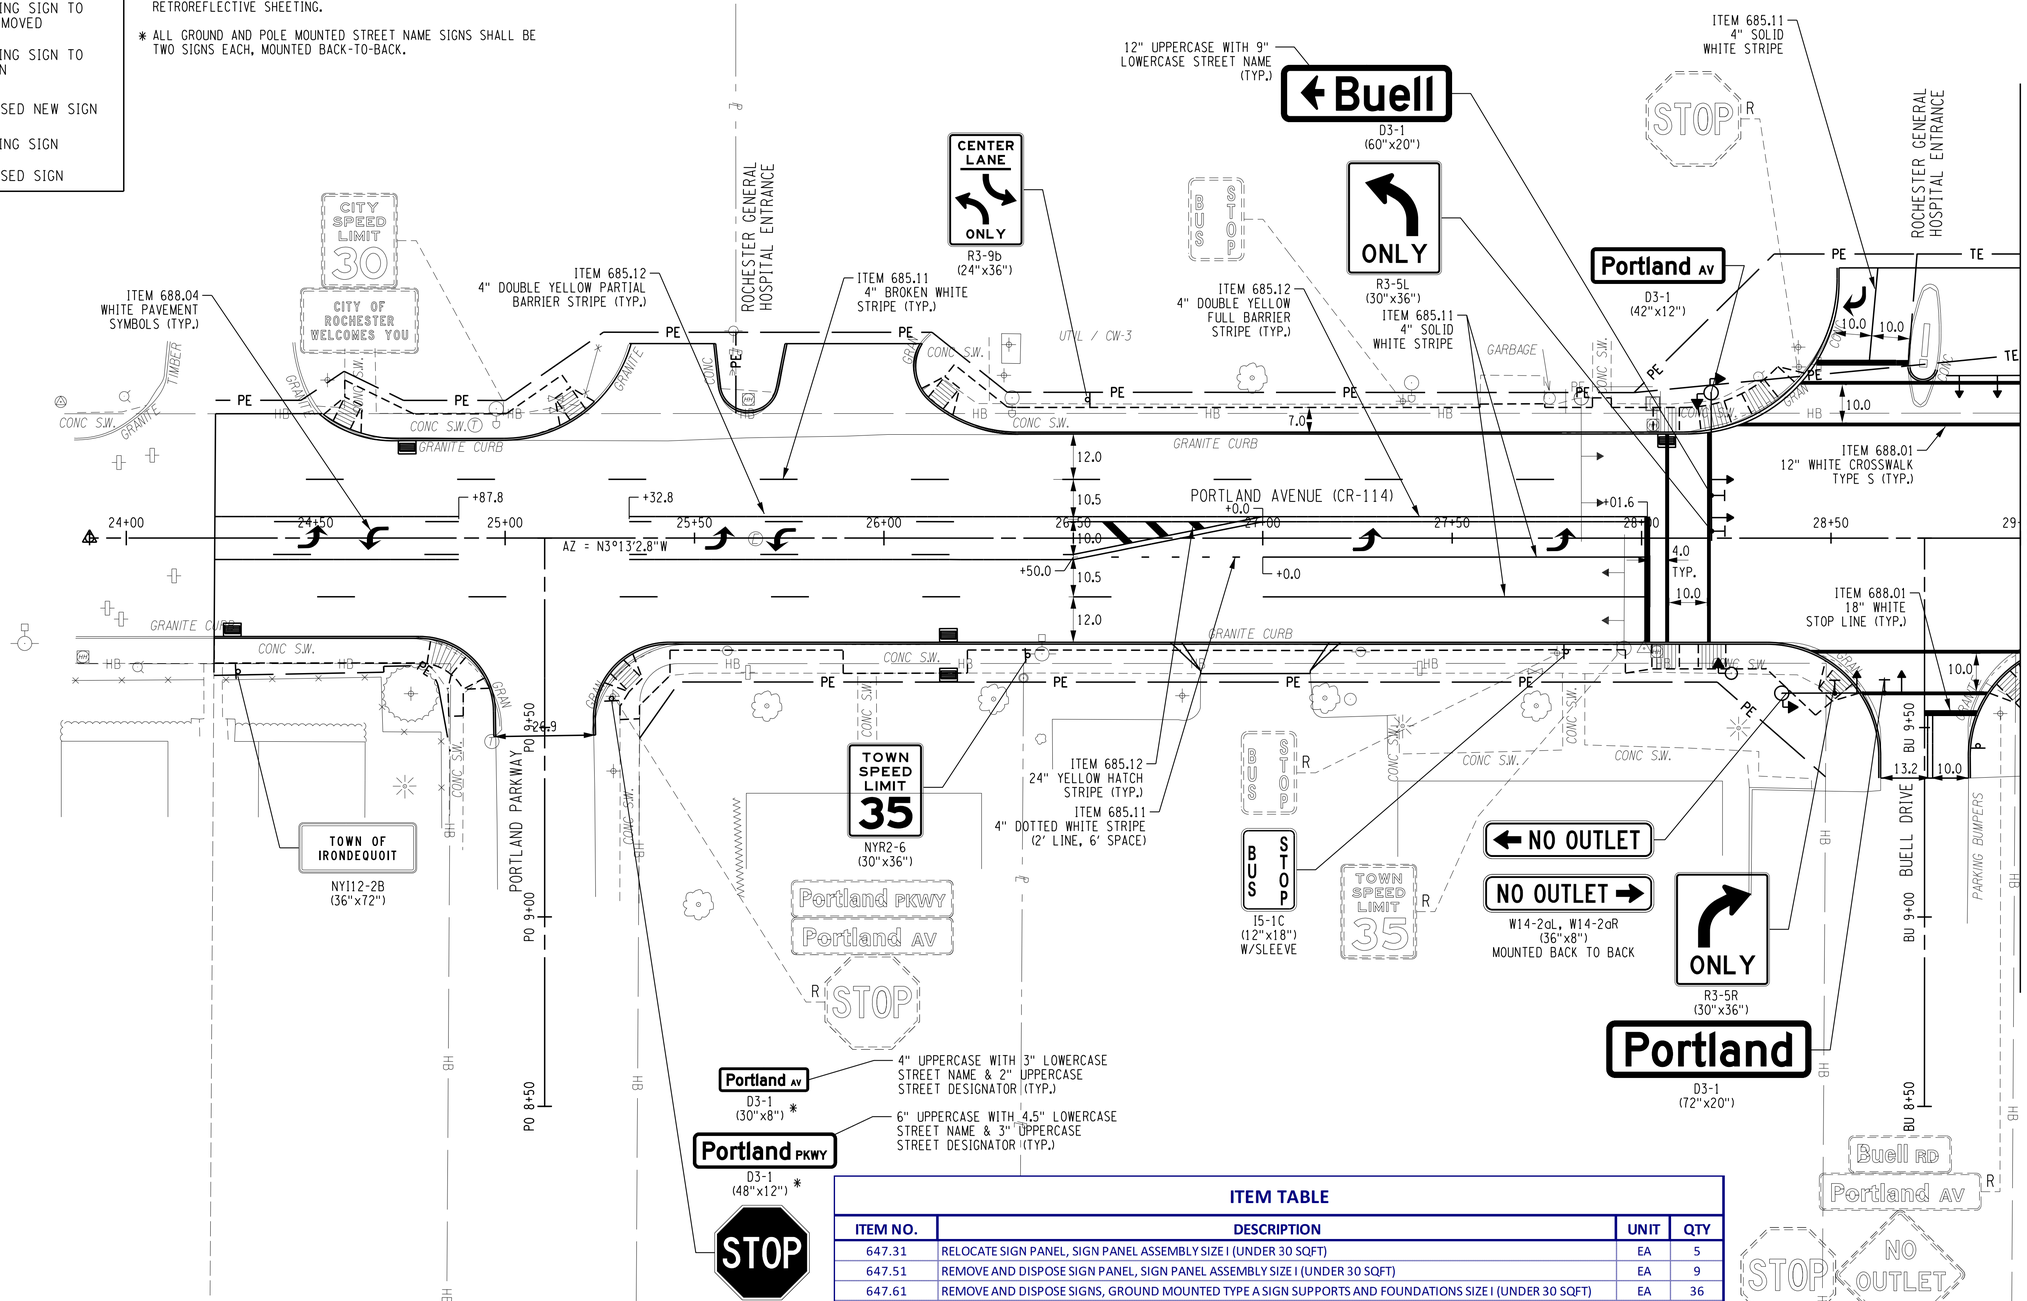

ITEM TABLE

ITEM NO.	DESCRIPTION	UNIT	QTY
647.31	RELOCATE SIGN PANEL, SIGN PANEL ASSEMBLY SIZE I (UNDER 30 SQFT)	EA	5
647.51	REMOVE AND DISPOSE SIGN PANEL, SIGN PANEL ASSEMBLY SIZE I (UNDER 30 SQFT)	EA	9
647.61	REMOVE AND DISPOSE SIGNS, GROUND MOUNTED TYPE A SIGN SUPPORTS AND FOUNDATIONS SIZE I (UNDER 30 SQFT)	EA	36
645.5101	GROUND MOUNTED SIGN PANELS, LESS THAN OR EQUAL TO 30 SQFT	312	SF
645.62	OVERHEAD SIGN PANELS WITH HIGH VISIBILITY SHEETING	57	SF
645.81	TYPE A SIGN POST	50	Ea
645.85	POLE MOUNTED SUPPORT SYSTEM	9	Ea

I HEREBY CERTIFY BY MY SIGNATURE AND SEAL BELOW, THAT I HAVE PREPARED THIS RECORD DRAWING WHICH IS, TO THE BEST OF MY KNOWLEDGE AND IN MY PROFESSIONAL OPINION, A TRUE REPRESENTATION OF THE WORK AS CONSTRUCTED FOR THE IMPROVEMENTS TO PORTLAND AVENUE, PROJECT NO. 4754.29.

NO.	DATE	BY:	REVISION
			ADDED R2-9B

LABELLA Associates, P.C.
300 STATE STREET
ROCHESTER, NY 14614
P: (585) 454-6110
F: (585) 454-3066

PROJECT MANAGER: W. DALEY
DRAWN BY: H. STEVENS

DEPARTMENT OF TRANSPORTATION
50 WEST MAIN STREET, SUITE 6100
ROCHESTER, NEW YORK 14614-1231

UNAUTHORIZED ALTERATION OR ADDITION TO THIS DRAWING IS A VIOLATION OF THE NEW YORK STATE EDUCATION LAW ARTICLE 145, SECTION 7209

COUNTY ROAD 114
PROJECT NAME: PORTLAND AVENUE
LIMITS: PORTLAND PARKWAY TO TITUS AVENUE
TOWN: IRONDEQUOIT, MONROE COUNTY
CAPITAL PROJECT NO. XXXX
NYSDOT P.I.N. 4754.29

RECORD DRAWING

SIGNING AND PAVEMENT MARKING PLANS

SCALE: 1"=20'
DATE ISSUED: NOV 2012
DRAWING NO. SM-1

FILE NAME = 209627_cph_smp_As Built.dgn
DATE/TIME = 1/26/2016 5:06:58 PM